

APPLICATION FOR PERMIT

SEWER-SEWAGE DISPOSAL

1

COUNTY OF LOS ANGELES
DEPARTMENT OF COUNTY ENGINEER
BUILDING AND SAFETY DIVISION
JOHN A. LAMBIE, County Engineer
CASSATT D. GRIFFIN, Sup't of Building

FOR APPLICANT TO FILL IN

LEGAL DESCRIPTION	LOT NO.
BLOCK	TRACT
SIZE OF LOT	NO. OF BLDGS. NOW ON LOT
USE OF BUILDINGS	
CONTRACTOR	
ADDRESS	
CITY	TEL. NO.
REGISTRATION NO.	STATE COUNTY

NO.	DESCRIPTION OF WORK	FEE
	HOUSE SEWER CONNECTING TO PUBLIC SEWER	@ \$3.00
	SEPTIC TANK, SEEPAGE PIT OR PITS AND/OR DRAINFIELD	@ \$3.00
	OVERFLOW SEEPAGE PIT, DRAINFIELD EXTN., CESSPOOL, DRYWELL	@ \$2.00
	HOUSE SEWER CONNECTING TO PRIVATE DISPOSAL SYSTEM	@ \$1.00
1	CONNECT ADDITIONAL BLDG. OR WORK TO HOUSE SEWER	@ \$1.00
2	ALTER, REPAIR OR ABANDON HOUSE SEWER OR DISPOSAL SYSTEM	@ \$1.00

OWNER'S AUTHORIZATION	PERMIT	\$	2 00
	TOTAL FEE		3 00

I HAVE AT THIS DATE A CONTRACT WITH THE HEREIN NAMED CONTRACTOR TO CONNECT THE ABOVE DESCRIBED EXISTING DWELLING TO THE PUBLIC SEWER.

SIGNED THIS _____ DAY OF _____ 19____

OWNER OR OWNERS AGENT _____

ADDRESS _____

I HEREBY ACKNOWLEDGE THAT I HAVE READ THIS APPLICATION AND STATE THAT THE ABOVE IS CORRECT AND AGREE TO COMPLY WITH ALL COUNTY ORDINANCES AND STATE LAWS REGULATING PLUMBING AND SEWERS.

I HEREBY CERTIFY THAT I AM PROPERLY REGISTERED AND/OR LICENSED AS REQUIRED BY LOS ANGELES COUNTY AND STATE OF CALIFORNIA OR THAT I AM THE LEGAL OWNER OF THE ABOVE DESCRIBED RESIDENTIAL PROPERTY.

SIGNATURE OF PERMITTEE _____

BUILDING ADDRESS	3600 E 3 rd
LOCALITY	E. L.A.
NEAREST CROSS ST.	Indiana
OWNER	Shell Oil
MAIL ADDRESS	6 th & Boylston
CITY	Los Angeles
TEL. NO.	Hu 2 7171

DISTRICT NO.	GROUP	MAP	PG	PROCESSED BY
6	E	BK	K 153A	E Bacon

CONNECTION DATA	
STATION	CD 13789
DEPTH	
MANHOLE REFERENCE	
UPPER	
LOWER	

TYPE OF CONNECTION	LENGTH FROM
Y. CURB	P.L. M.I. TO P.L.

CO. IMP. NO.	P. C. NO.
	JOB NO. P11537

TRUNK PERMIT NO.	ROAD PERMIT NO.
------------------	-----------------

STATE ENCROACHMENT PERMIT NO.

INDUSTRIAL WASTE APPROVAL

CHARGES

CONNECTION CHARGE FEE

REIMBURSEMENT FEE

APPROVALS	DATE	INSPECTOR'S SIGNATURE
NEW HOUSE SEWER		
CONNECT ADDITIONAL BUILDING OR WORK	4-24-61	Cornas
SEPTIC TANK, SEEP. PIT(S) AND/OR DRAINFIELD		
CESSPOOL <input type="checkbox"/> DRYWELL <input type="checkbox"/>		
ALTER, REPAIR, SEWER OR SEWAGE DISPOSAL SYSTEM		
DISCONNECT PLUG AND ABANDON HOUSE SEWER		
BACKFILL SEPTIC TANKS <input type="checkbox"/>		
SEEP. PIT(S) <input type="checkbox"/> CESSPOOLS <input type="checkbox"/>		

VALIDATION

CK. M. O. CASH

ROBERT A. WOOD

SUPERVISING MECHANICAL ENGINEER

LA 73085 APR 18 1961


3.00

E Bacon

REQUIRED INFORMATION

1. INDICATE ALL BUILDINGS ON PROPERTY.
2. INDICATE AND DIMENSION SEWAGE DISPOSAL SYSTEM WITH TIE DISTANCES TO BUILDINGS AND PROPERTY LINES.
3. INDICATE SIZE OF SEPTIC TANK—DEPTH OF SEEPAGE PIT(S)—SIZE OF CESSPOOL(S).
4. INDICATE NORTH DIRECTION ON PLOT.
5. INDICATE BOTH STREETS IF CORNER.

North
↓

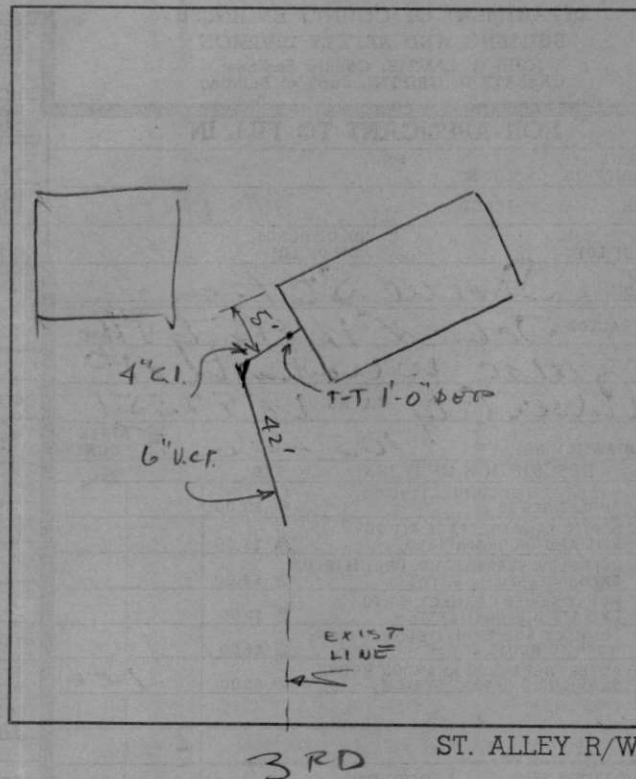

INDIANNA

3RD ST. ALLEY R/W

FIELD NOTES